

"U.S. PUBLIC LAND SURVEY MONUMENT RECORD" OZAUKEE COUNTY, WISCONSIN

TYPE OF MONUMENT: CONCRETE MONUMENT WITH BRASS CAP

STATE PLANE COORDINATES: N: 500420.04

E: 2562904.54

ELEVATION: 689.61 M.S.L. DATUM: 1929

FIELD BOOK: 3 PAGE: 5

FIELDWORK BY: Tom Genske & KAPUR & ASSOC 1995

RECORD DRAWN BY: MARK BANTON

CONTROL ACCURACY:


HORIZONTAL: 3RD ORDER CLASS 1 VERTICAL: 3RD ORDER

CORNER INDEX No. 427-4

SECTION 3

TOWNSHIP 10

RANGE 22

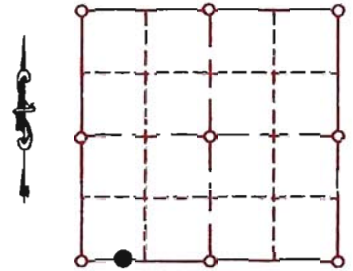

LOCATION

SEAL:



BASIS OF MONUMENT LOCATION

1995- Tom Genske (County Surveyor) using existing record surveys, a 3/4" rebar was set on line between 3 & 10 by Kapur & Assoc. Replaced rebar with Concrete monument with brass cap.

DATA SHOWN HEREON
IS CERTIFIED AS CORRECT:

Mark Banton
Ozaukee County Surveyor

DATE: 1/24/08

TIE SKETCH


- A = 21.98' @ 13°
- B = 3.36' @ 80°
- C = 21.32' @ 184°
- D = 12.35' @ 253°

Dhn/disc eastside 5" ash
1' above grd

Dhn/disc southside
9" ash 0.5' above grd

Dhn/disc northside
5" ash 1' above grd

Dhn/disc eastside
7" ash 0.8' above grd

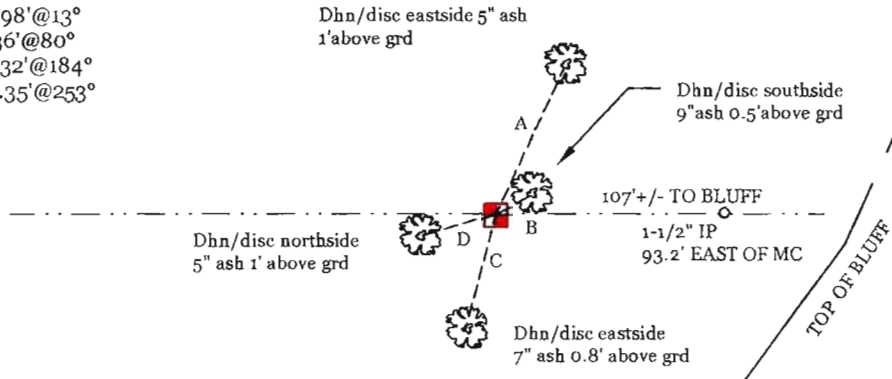

MAINTENANCE RECORD

- MONUMENT LEGEND
- = BERNTSEN MONUMENT (SEE TYPE OF MON. ABOVE)
 - = CONCRETE MONUMENT w/ BRASS CAP
 - = CONCRETE MONUMENT w/ CROSS
 - = 5/8" REBAR WITH ALUMINUM CAP

DATE	BY WHOM	REMARKS
1/24/08	Mark Banton	draw from T. Genske fieldnotes